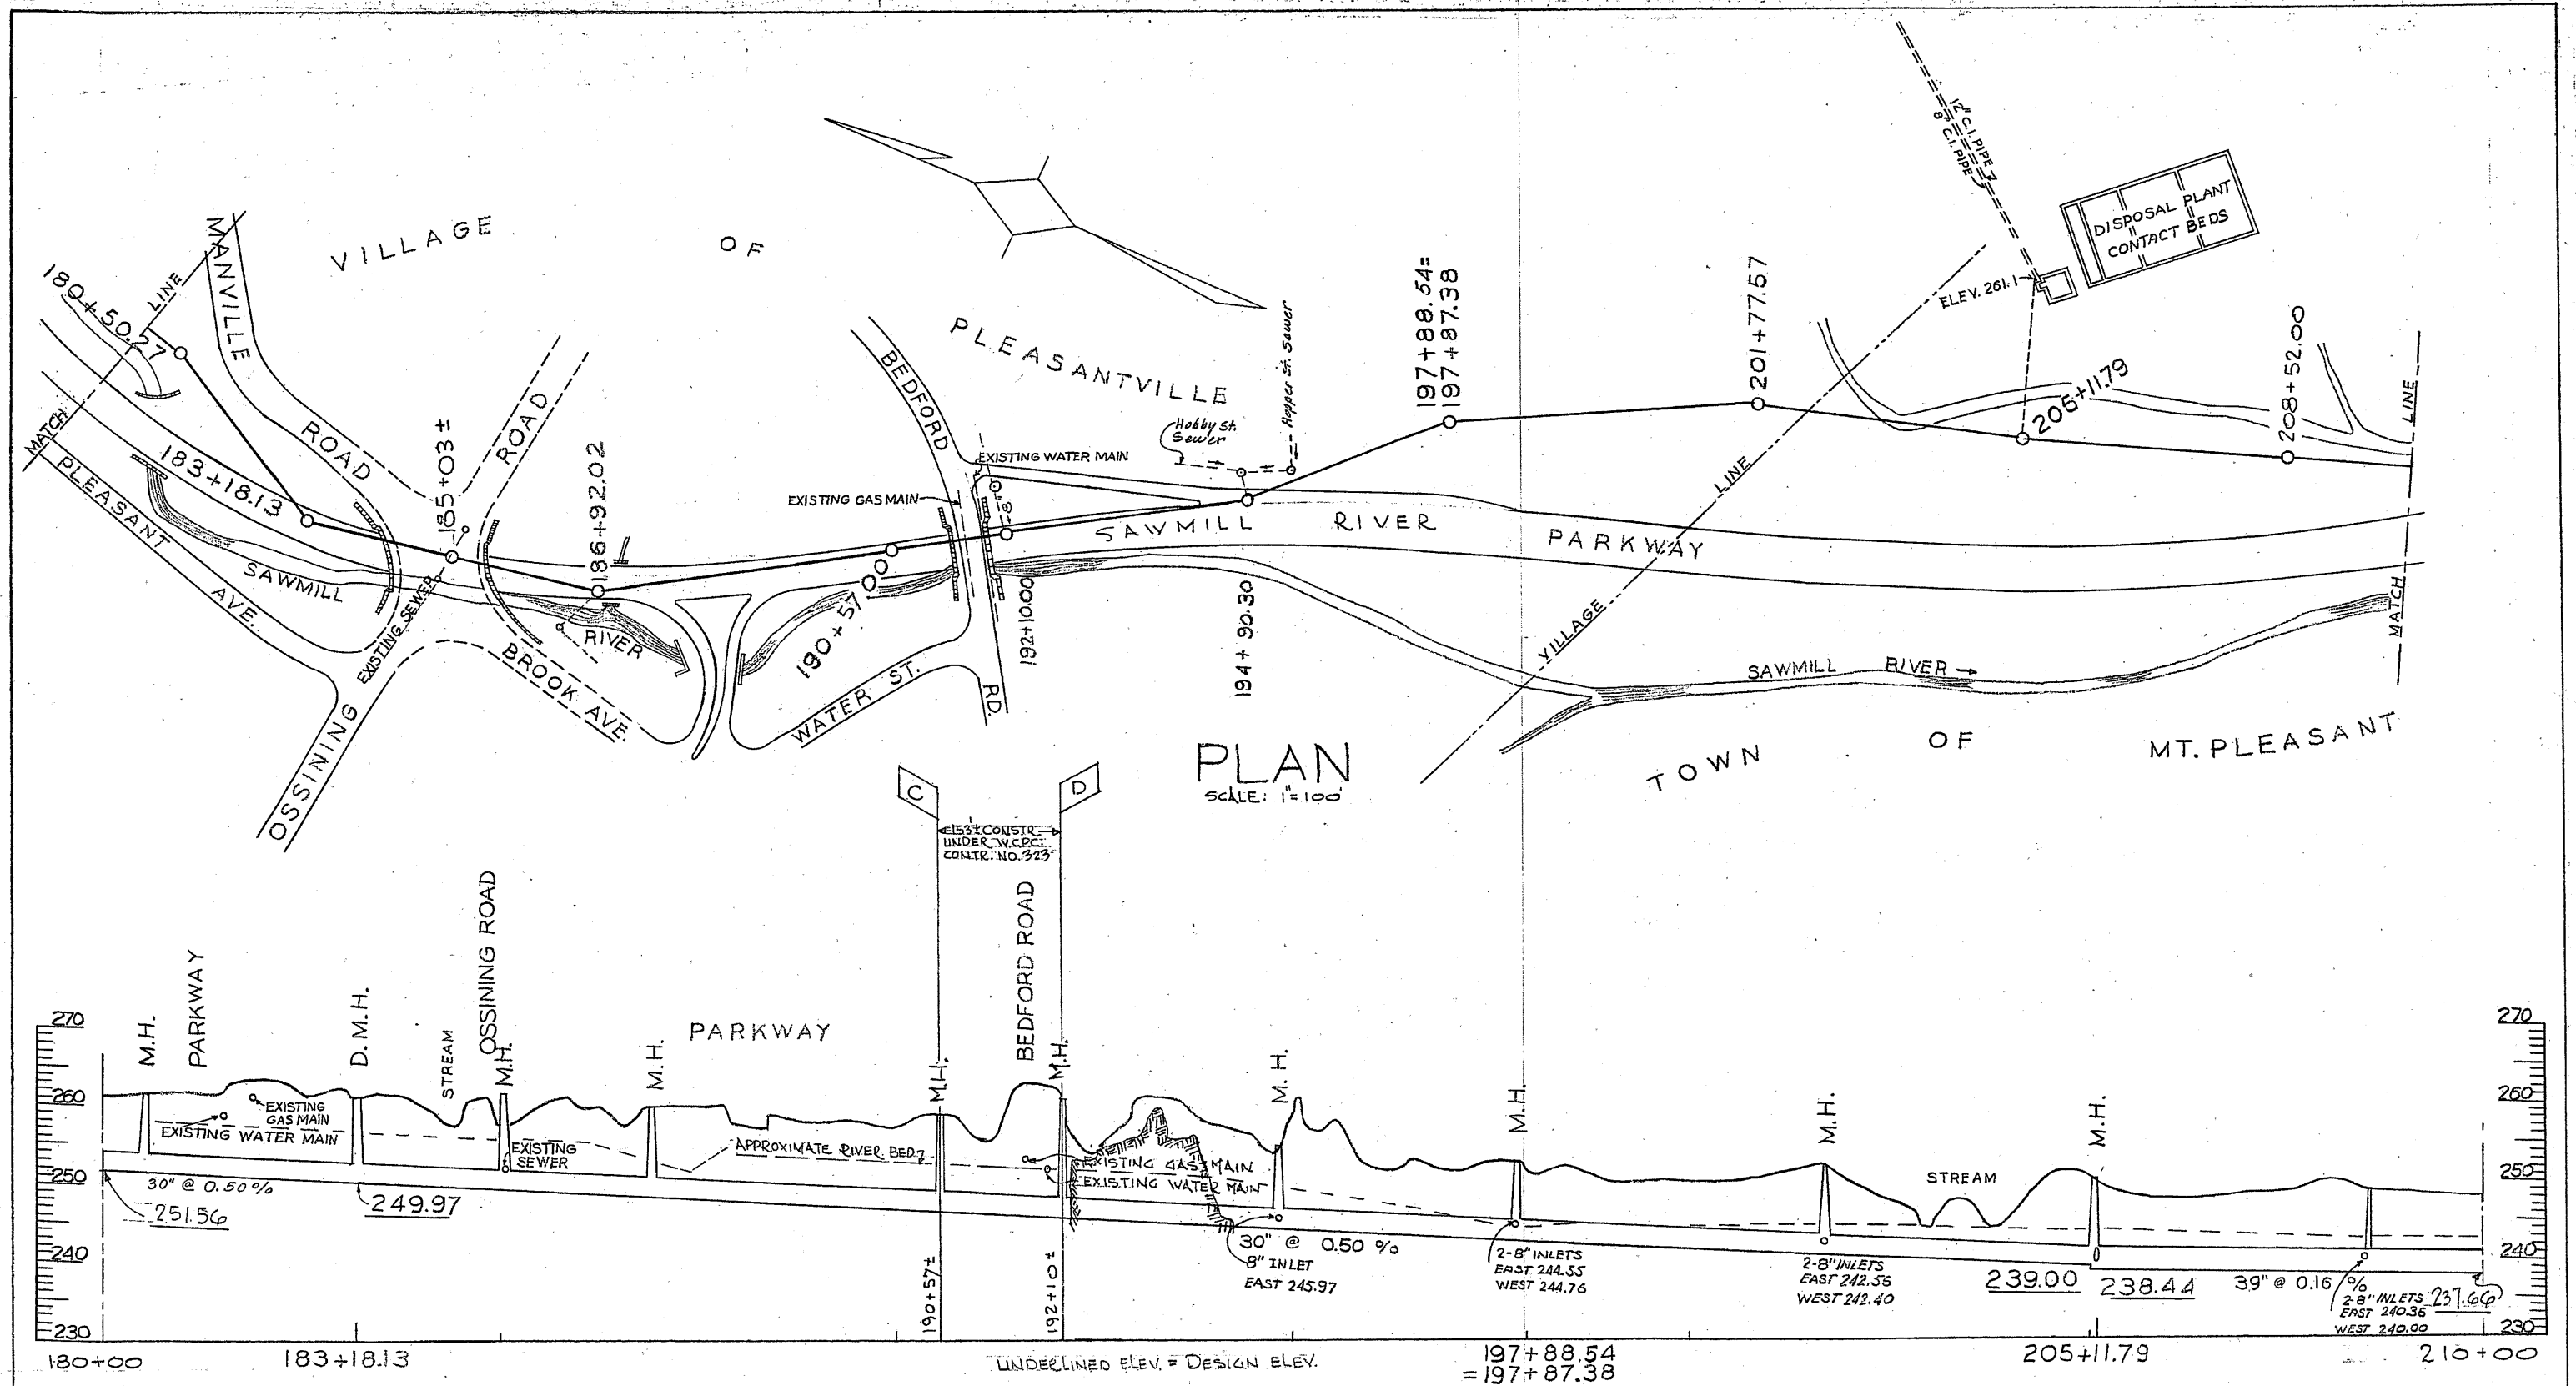

RECORD DRAWING
WESTCHESTER COUNTY
SANITARY SEWER COMMISSION
TRUNK SEWER SECTION C & D
SAW MILL PROJECT

MARCH 1967 T.C.H.

SM-7

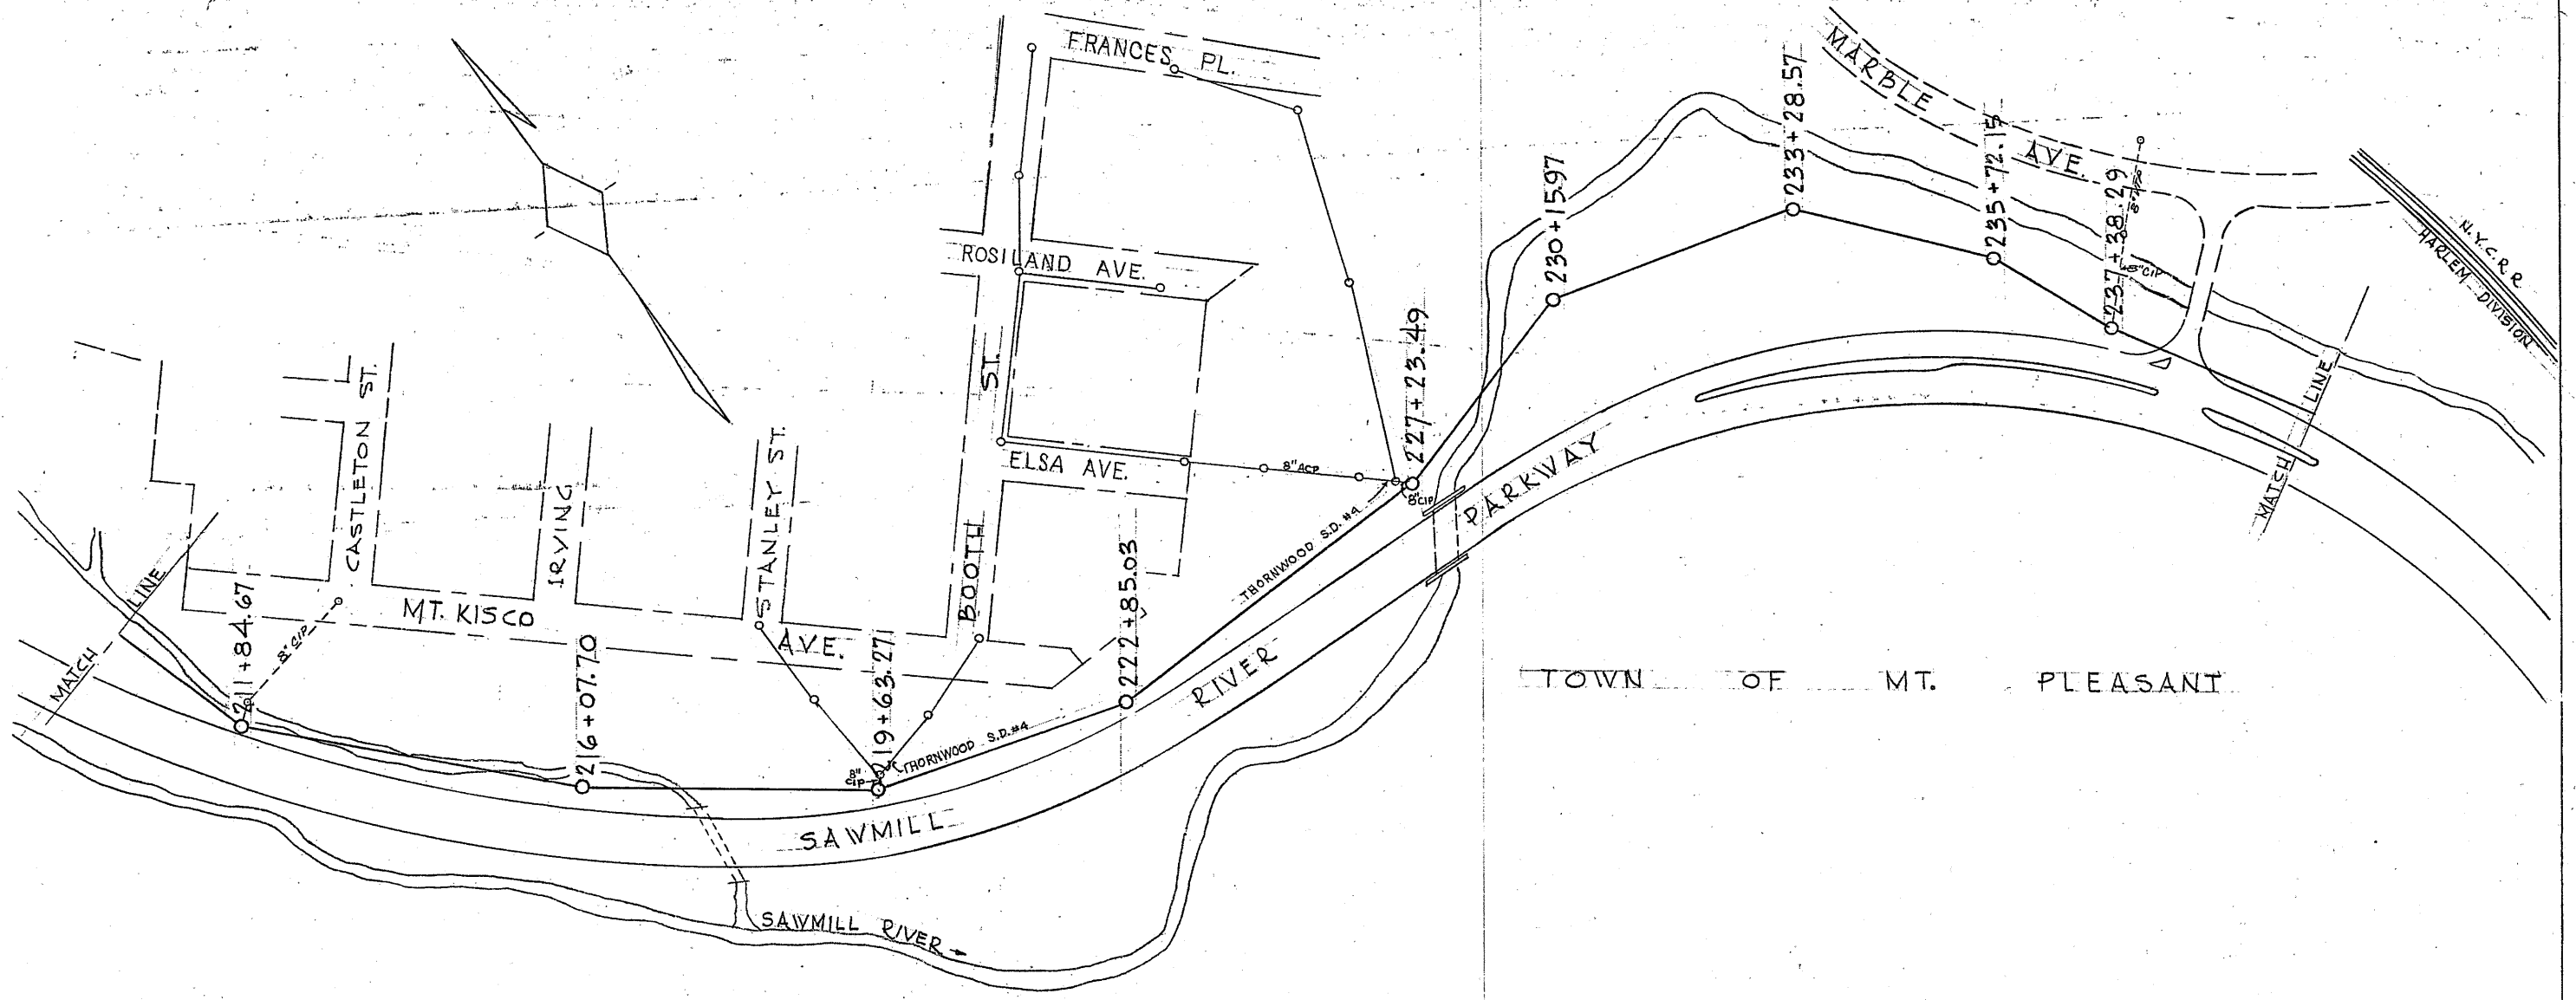

PLAN

SCALE: 1" = 100'

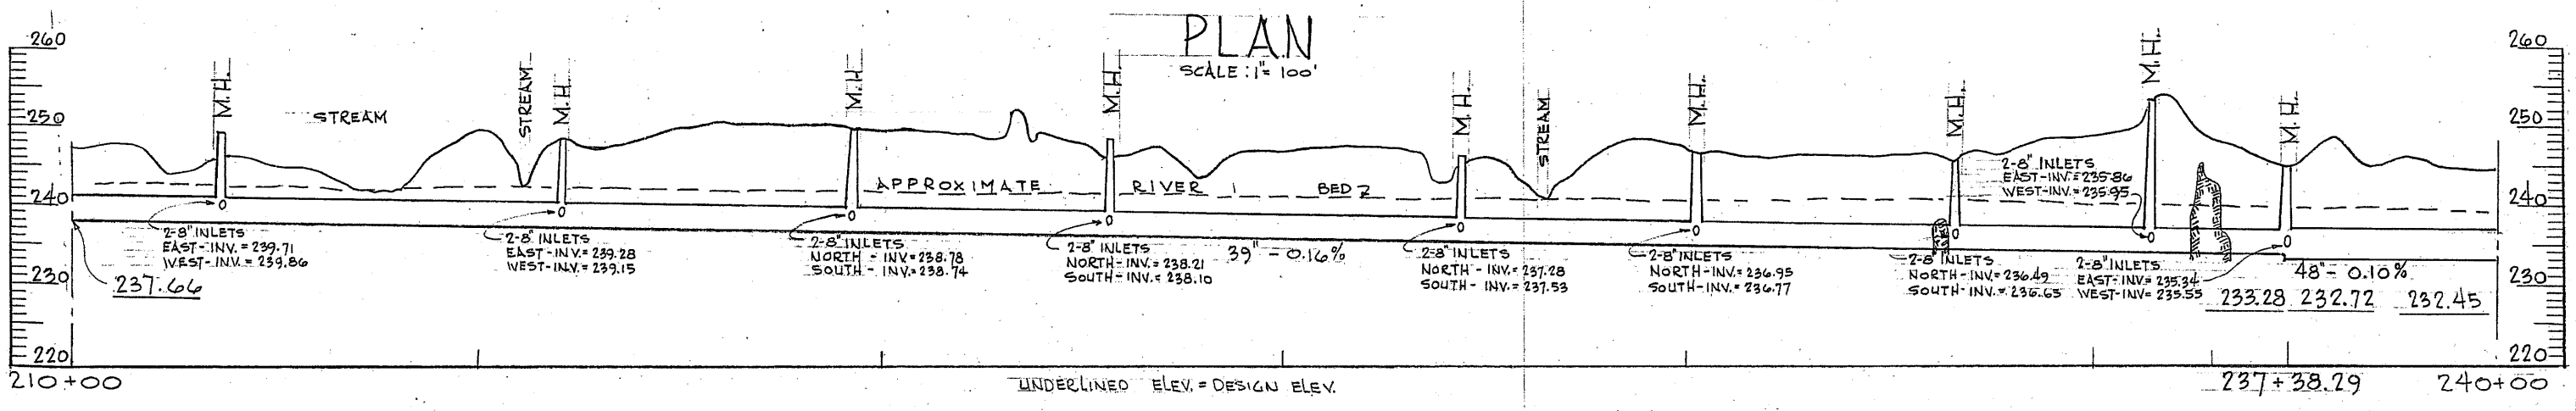

UNDERLINED ELEV. = DESIGN ELEV.

PROFILE

SCALES: HOR. 1" = 100'
VERT. 1" = 10'

RECORD DRAWING
WESTCHESTER COUNTY
SANITARY SEWER COMMISSION
TRUNK SEWER SECTION D
SAWMILL PROJECT

MARCH 1967 E.R.T.

SM - 8

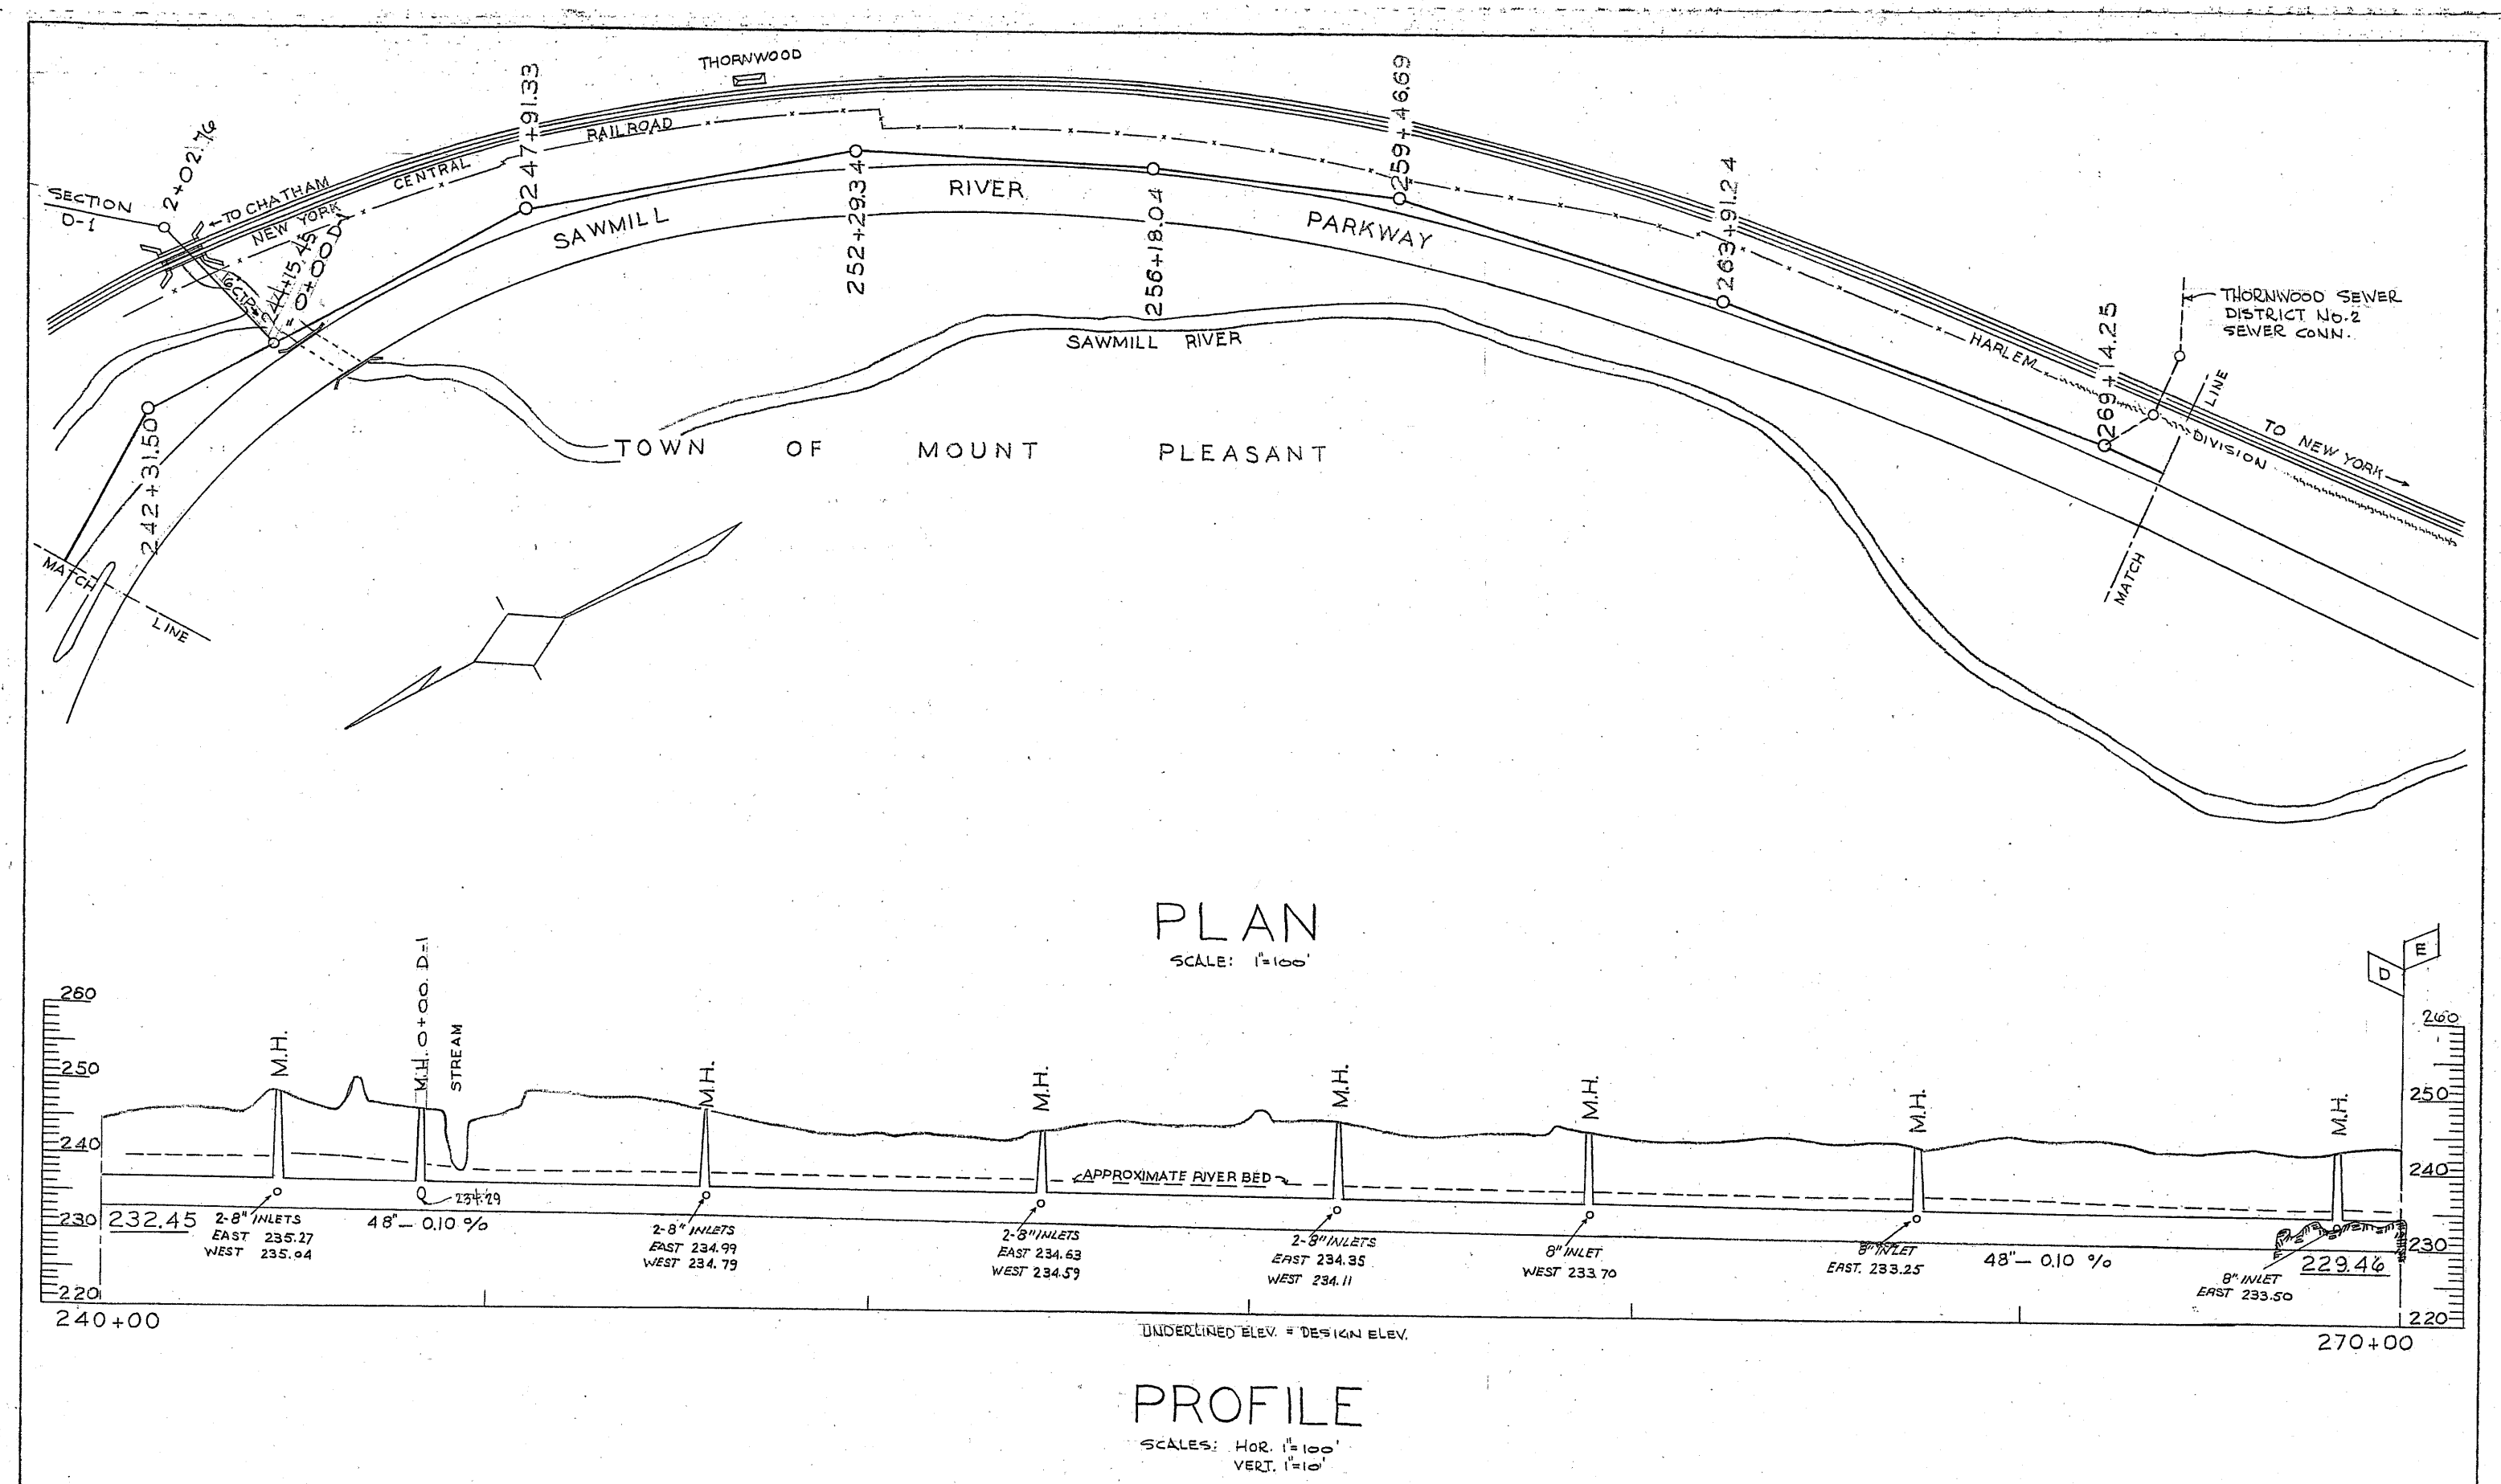

RECORD DRAWING
WESTCHESTER COUNTY
SANITARY SEWER COMMISSION
TRUNK SEWER SECTION D
SAW MILL PROJECT

MARCH 1967 T.C.H.

CM-9

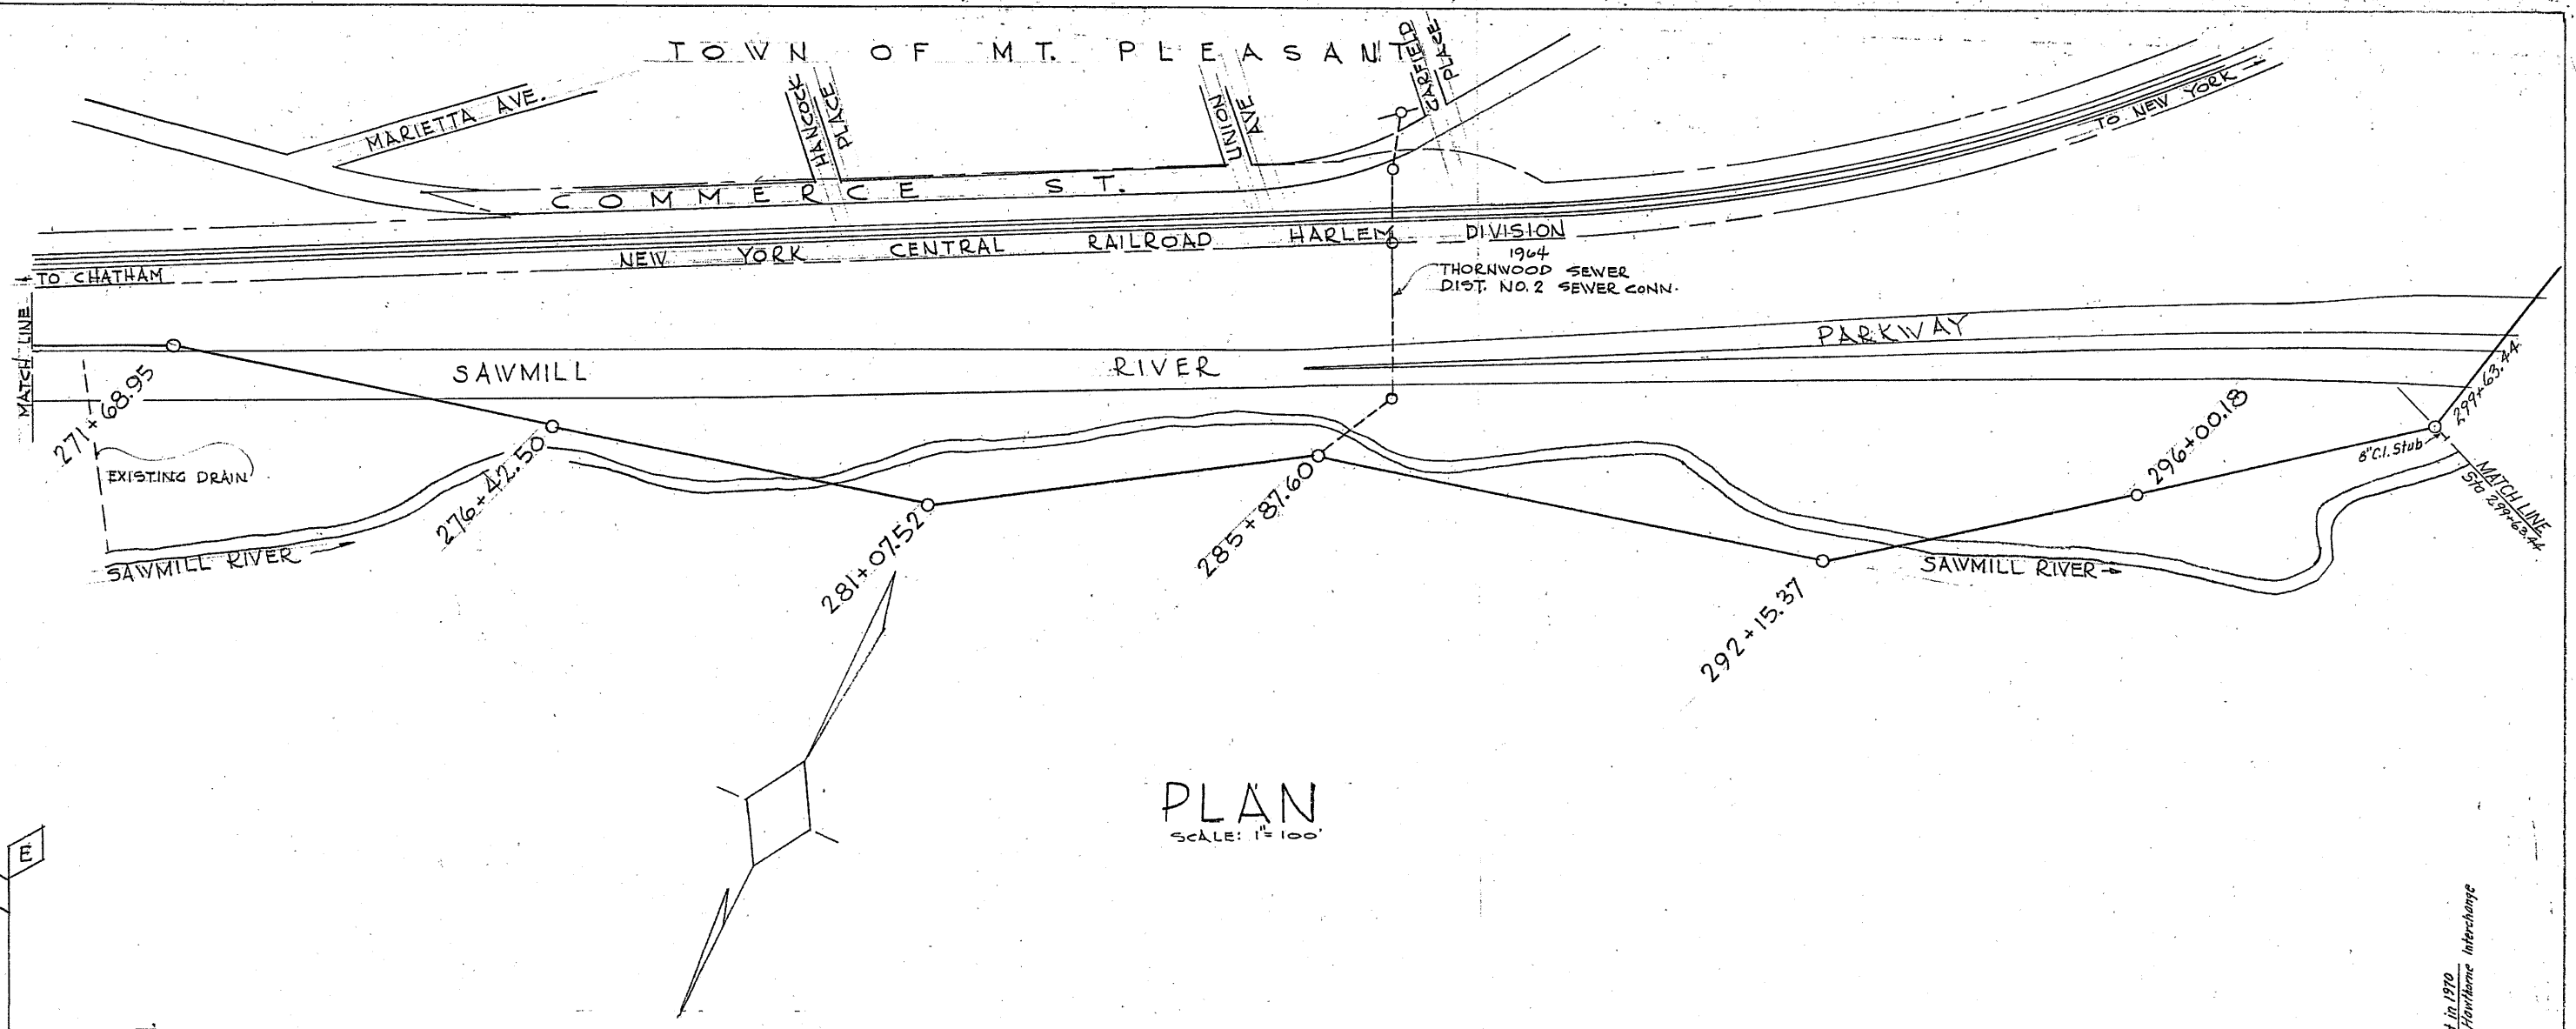

PLAN

SCALE: 1" = 100'

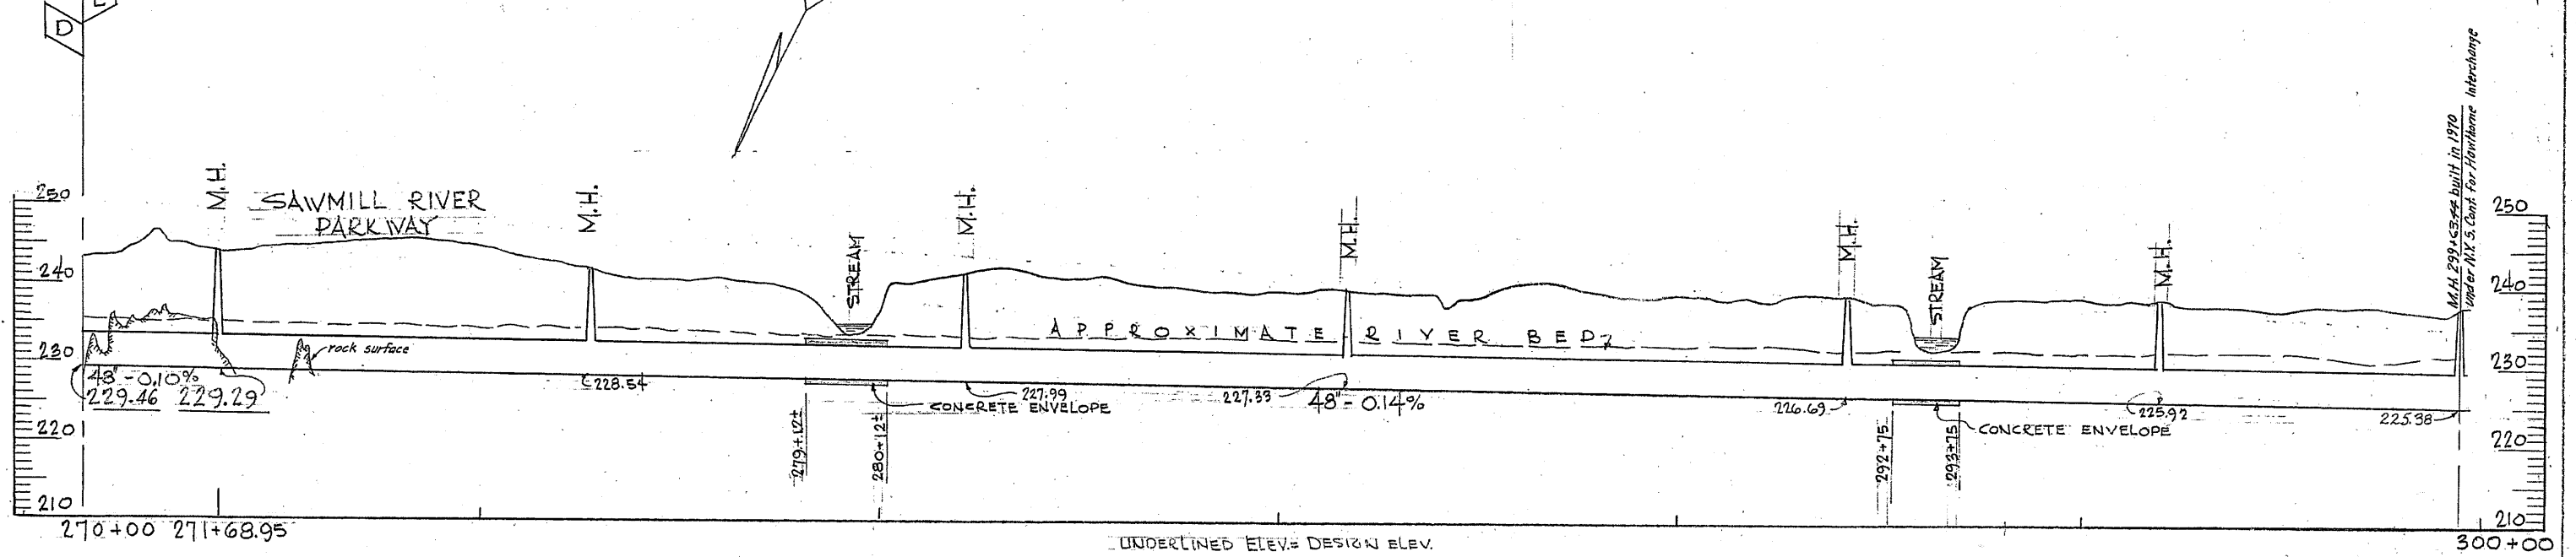

PROFILE

SCALES: HOR. 1" = 100'
VERT. 1" = 10'

RECORD DRAWING
WETCHESTER COUNTY
SANITARY SEWER COMMISSION
TRUNK SEWER SECTION E
SAWMILL PROJECT

Revised MAR '71 S.A.C.
Revised Feb. '70 C.A.M.

MARCH 1967 E.R.T.